

SECOND FLOOR
 1066 SQ. FT. (EXCLUDES:
 AREA LABELED "OPEN TO BELOW")


S:\CAD\Comment\111111-688\units5&6\CONDO-PLANS\M1688-CU5-2.dwg, 68/64/2003 03:14:22 PM, gottip, 1:1

I CERTIFY THAT THIS PLAN SHOWS THE UNIT DESIGNATION OF THE UNIT BEING CONVEYED AND OF IMMEDIATELY ADJOINING UNITS, AND THAT IT FULLY AND ACCURATELY DEPICTS THE LAYOUT OF THE UNIT, ITS LOCATION, APPROXIMATE AREA, MAIN ENTRANCE AND IMMEDIATE COMMON AREA TO WHICH IT HAS ACCESS, AS-BUILT.

[Signature]
 REGISTERED ARCHITECT

- NOTES:
1. DIMENSIONS SHOWN HEREON ARE TO THE FACE OF FRAMING.
 2. REFERENCE ELEVATION:
 SECOND FLOOR - 119'-4"


SHEET 3 OF 3

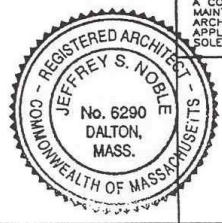

A COPY OF THE DATA IN THIS DRAWING FILE IS MAINTAINED AT THE OFFICES OF HILL ENGINEERS ARCHITECTS, PLANNERS, INC. THE INTERPRETATION, APPLICATION AND REVISION OF THIS DATA IS THE SOLE RESPONSIBILITY OF THE USER.



CONDOMINIUM UNIT PLAN			
SHOWING UNIT #5,		TWELVE OAKS VILLAGE	
ROUTES 7 & 20,		LENOX, MA	
SCALE	1/16" = 1'-0"	REV.	
DATE	8/4/03	DESCRIPTION	
DRW.	PG	CHK'D.	
APP'VD.			
COMP. CODE		BOOK NO.	
		CAD CODE	M1688-CU5-2.DWG
TITLE	SECOND FLOOR PLAN UNIT #5		NO. M1688-CU5-2
			REV.

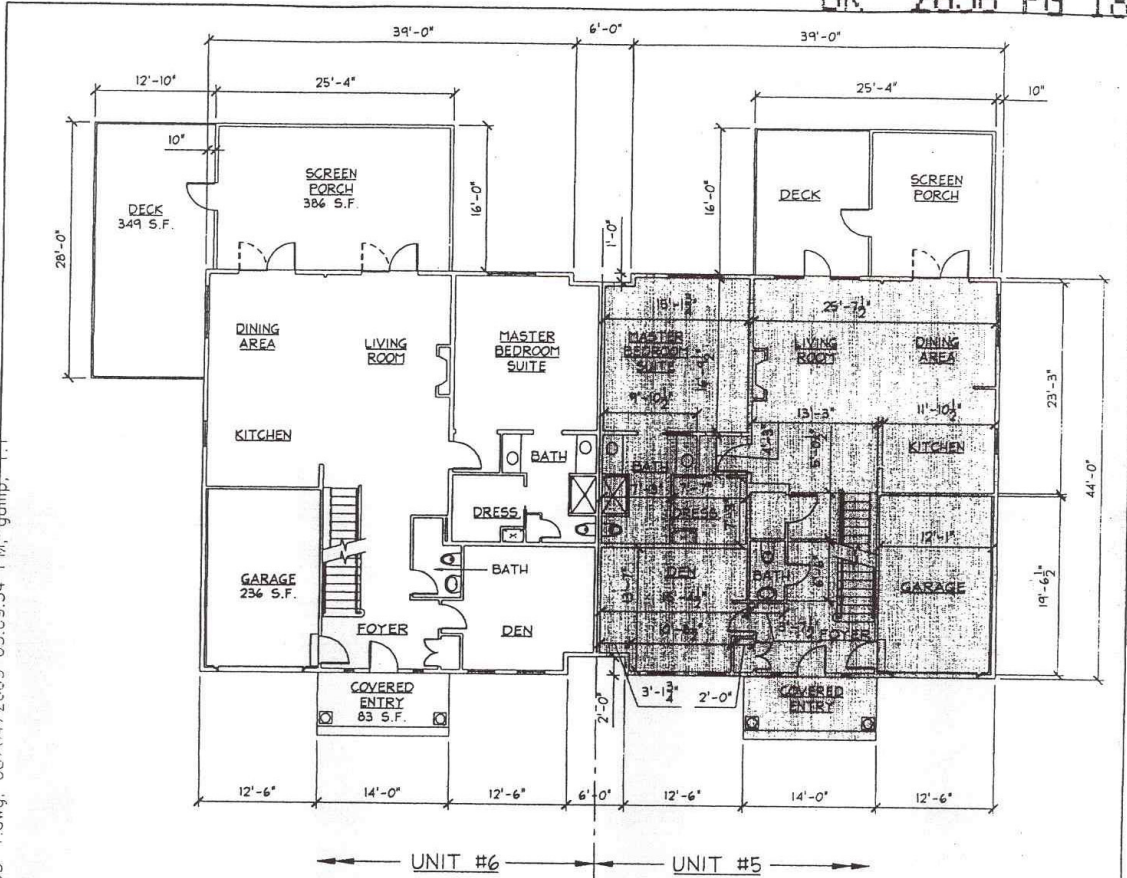


FIRST FLOOR
 1521 SQ. FT., (EXCLUDES:
 AREAS OF DECK, SCREEN PORCH,
 COVERED ENTRY AND GARAGE)

I CERTIFY THAT THIS PLAN SHOWS THE UNIT DESIGNATION OF THE UNIT BEING CONVEYED AND OF IMMEDIATELY ADJOINING UNITS, AND THAT IT FULLY AND ACCURATELY DEPICTS THE LAYOUT OF THE UNIT, ITS LOCATION, APPROXIMATE AREA, MAIN ENTRANCE AND IMMEDIATE COMMON AREA TO WHICH IT HAS ACCESS, AS-BUILT.

[Signature]
 REGISTERED ARCHITECT

- NOTES:
1. DIMENSIONS SHOWN HEREON ARE TO THE FACE OF FRAMING.
 2. REFERENCE ELEVATION:
 FIRST FLOOR - 109'-4 1/2"

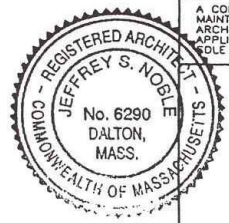


A COPY OF THE DATA IN THIS DRAWING FILE IS MAINTAINED AT THE OFFICES OF HILL ENGINEERS ARCHITECTS, PLANNERS, INC. THE INTERPRETATION, APPLICATION AND REVISION OF THIS DATA IS THE SOLE RESPONSIBILITY OF THE USER.

Hill
 engineers
 architects
 planners
 50 Depot Street
 Dalton, MA 01226
 (413) 684-0925
 www.hillengineers.com

CONDOMINIUM UNIT PLAN SHOWING UNIT #5, TWELVE OAKS VILLAGE ROUTES 7 & 20, LENOX, MA			
SCALE	1/16" = 1'-0"	REV.	
DATE	8/4/03	DRN.	CR'D.
DRN.	PG	CK'D.	
APP'VD.			
COMP. CODE		BOOK NO.	
TITLE		NO.	REV.
FIRST FLOOR PLAN UNIT #5		CAG CODE M1688-CU5-1.DWG	NO. M1688-CU5-1

SHEET 2 OF 3

S:\CADD\Current\11-11-06\1688\units5&6\CONDO-PLANS\M1688-CU5-1.dwg, 6/27/07 2:05:34 PM, galling, 1:1

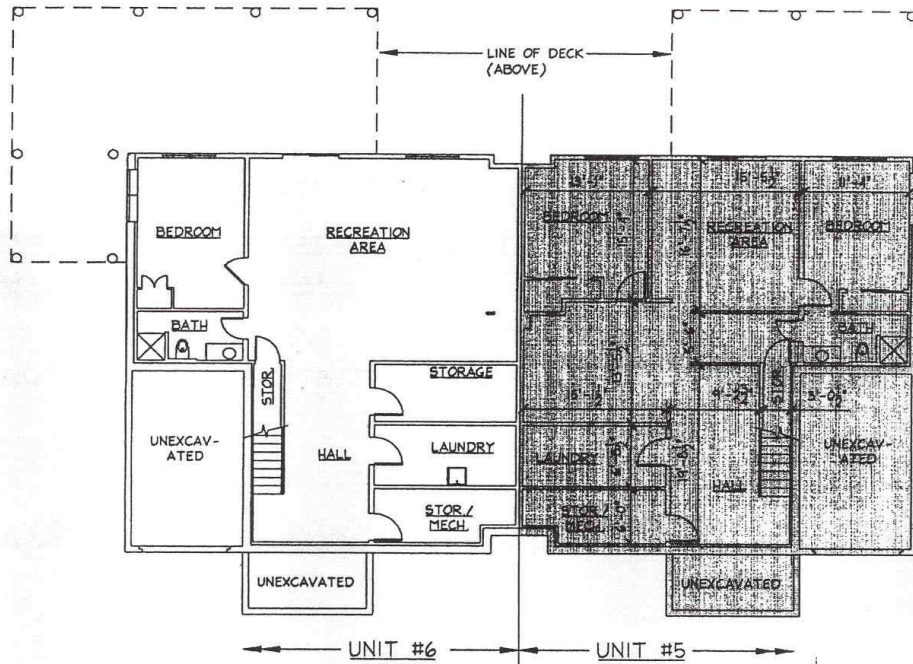

BASEMENT
 1460 SQ. FT. (EXCLUDES:
 AREAS LABELED "UNEXCAVATED")

I CERTIFY THAT THIS PLAN SHOWS THE UNIT DESIGNATION OF THE UNIT BEING CONVEYED AND OF IMMEDIATELY ADJOINING UNITS, AND THAT IT FULLY AND ACCURATELY DEPICTS THE LAYOUT OF THE UNIT, ITS LOCATION, APPROXIMATE AREA, MAIN ENTRANCE AND IMMEDIATE COMMON AREA TO WHICH IT HAS ACCESS, AS-BUILT.

NOTES:

1. DIMENSIONS SHOWN HEREON ARE TO THE FACE OF FRAMING.
2. REFERENCE ELEVATION:
 BASEMENT FLOOR - 100'-0"

[Signature]
 REGISTERED ARCHITECT

SHEET 1 OF 3



A COPY OF THE DATA IN THIS DRAWING FILE IS MAINTAINED AT THE OFFICES OF HILL ENGINEERS, ARCHITECTS, PLANNERS, INC. THE INTERPRETATION, REPLICATION AND REVISION OF THIS DATA IS THE SOLE RESPONSIBILITY OF THE USER.

Hill
 engineers
 architects
 planners
 50 Depot Street
 Dalton, MA 01226
 (413) 684-0925
 www.hillengineers.com

CONDOMINIUM UNIT PLAN			
SHOWING UNIT #5, TWELVE OAKS VILLAGE ROUTES 7 & 20, LENOX, MA			
SCALE	1/16"=1'-0"	REV.	DESCRIPTION
DATE	8/4/03	DRW'N	CR'D.
DRW'N	PG	CR'D.	
AP'VD.			
COMP. CODE	BOOK NO.	CAD CODE	M1688-CU5-B.DWG
TITLE	BASEMENT FLOOR PLAN UNIT #5		NO. M1688-CU5-B REV.