

SECOND FLOOR
 1132 SQ. FT. (EXCLUDES:
 AREA LABELED "OPEN TO BELOW")

I CERTIFY THAT THIS PLAN SHOWS THE UNIT DESIGNATION OF THE UNIT BEING CONVEYED AND OF IMMEDIATELY ADJOINING UNITS, AND THAT IT FULLY AND ACCURATELY DEPICTS THE LAYOUT OF THE UNIT, ITS LOCATION, APPROXIMATE AREA, MAIN ENTRANCE AND IMMEDIATE COMMON AREA TO WHICH IT HAS ACCESS, AS-BUILT.

NOTES:


1. DIMENSIONS SHOWN HEREON ARE TO THE FACE OF FRAMING.
2. REFERENCE ELEVATION:
 SECOND FLOOR - 119'-4"

[Signature]
 REGISTERED ARCHITECT

SHEET 3 OF 3

		CONDOMINIUM UNIT PLAN SHOWING UNIT #6, TWELVE OAKS VILLAGE ROUTES 7 & 20, LENOX, MA			
		SCALE: 1/16" = 1'-0" DATE: 5/27/03 DRN: PG APP'G:	REV: DESCRIPTION DRN: CR'D: DATE:	COMP. CODE: BOOK NO.: CAD CODE: M1688-CU6-2.DWG	TITLE: SECOND FLOOR PLAN UNIT #6 NO.: M1688-CU6-2 REV:

END OF DOCUMENT

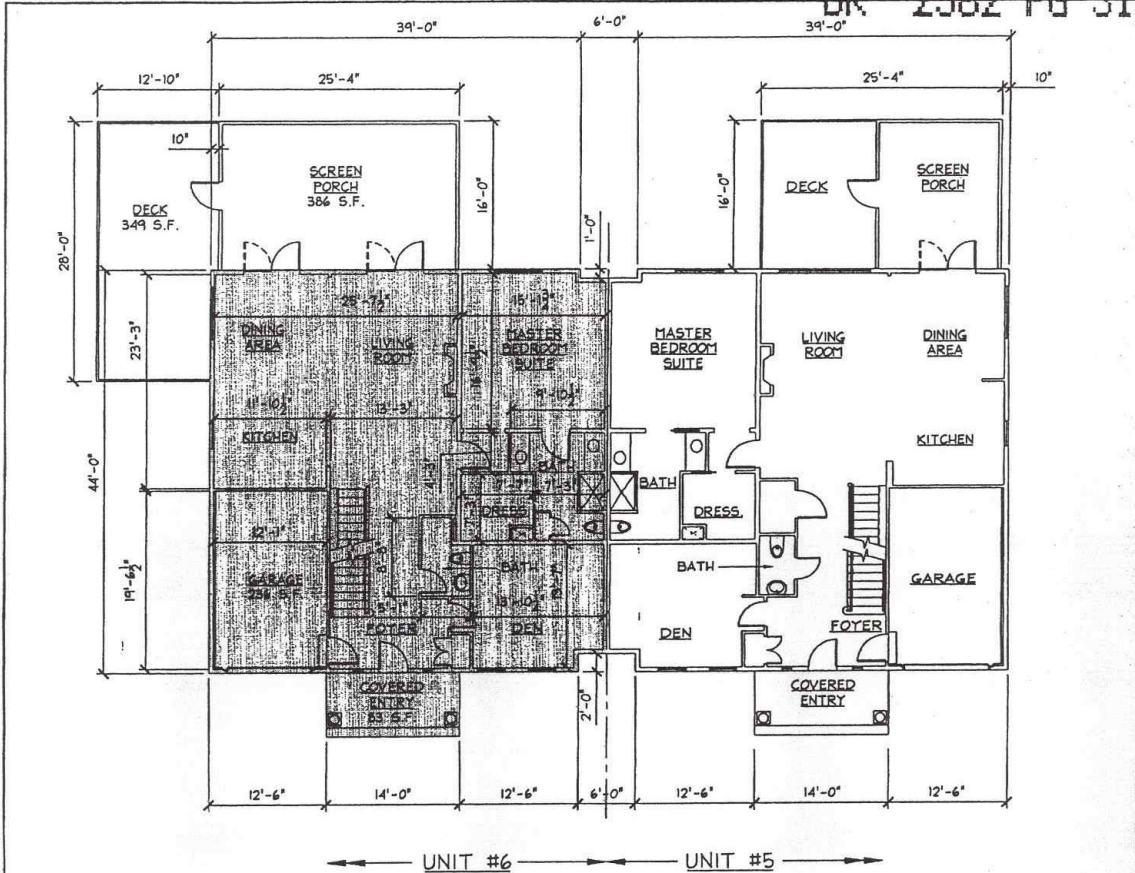

FIRST FLOOR
 1521 SQ. FT., (EXCLUDES:
 AREAS OF DECK, SCREEN PORCH,
 COVERED ENTRY AND GARAGE)

I CERTIFY THAT THIS PLAN SHOWS THE UNIT DESIGNATION OF THE UNIT BEING CONVEYED AND OF IMMEDIATELY ADJOINING UNITS, AND THAT IT FULLY AND ACCURATELY DEPICTS THE LAYOUT OF THE UNIT, ITS LOCATION, APPROXIMATE AREA, MAIN ENTRANCE AND IMMEDIATE COMMON AREA TO WHICH IT HAS ACCESS, AS-BUILT.


[Signature]
 REGISTERED ARCHITECT

NOTES:

1. DIMENSIONS SHOWN HEREON ARE TO THE FACE OF FRAMING.
2. REFERENCE ELEVATION:
 FIRST FLOOR - 10'-4 1/2"

SHEET 2 OF 3

<p>A COPY OF THE DATA IN THIS DRAWING FILE IS MAINTAINED AT THE OFFICES OF HILL ENGINEERS, ARCHITECTS, PLANNERS, INC. THE INTERPRETATION, REVISION AND REVISION OF THIS DATA IS THE SOLE RESPONSIBILITY OF THE USER.</p>		<p>CONDOMINIUM UNIT PLAN SHOWING UNIT #6, TWELVE OAKS VILLAGE ROUTES 7 & 20, LENOX, MA</p>	
		SCALE: 1/16" = 1'-0"	REV.
		DATE: 5/30/03	DRW. CK'D.
		DRW. PG.	CHK'D.
		APP'VD.	
COMP. CODE: _____ BOOK NO.: _____ CAD CODE: M1688-CU6-1.DWG		NO.: _____ REV.: _____	
TITLE: FIRST FLOOR PLAN UNIT #6		NO.: M1688-CU6-1	

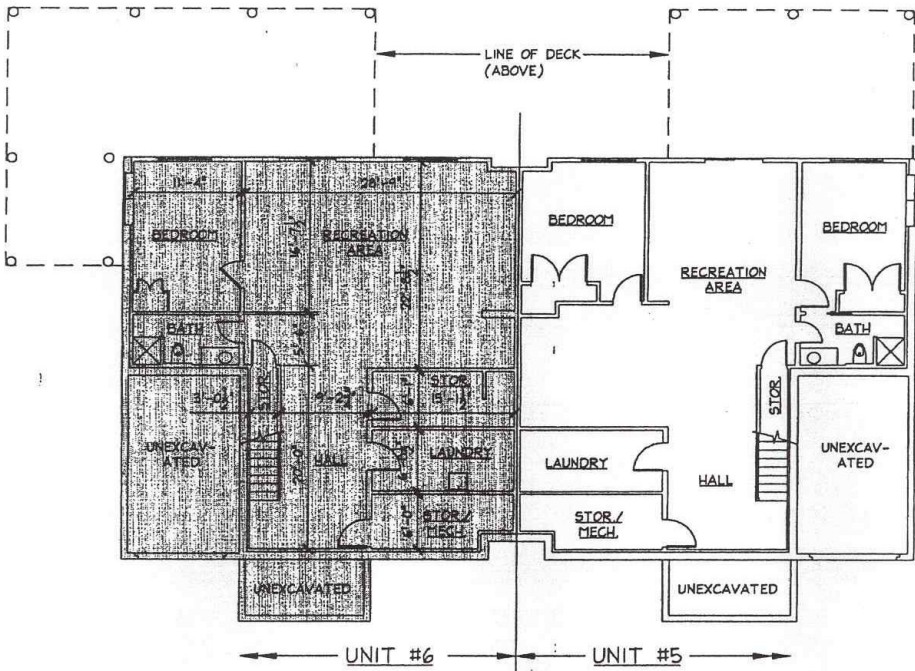

BASEMENT
 1460 SQ. FT. (EXCLUDES:
 AREAS LABELED "UNEXCAVATED")


I CERTIFY THAT THIS PLAN SHOWS THE UNIT DESIGNATION OF THE UNIT BEING CONVEYED AND OF IMMEDIATELY ADJOINING UNITS, AND THAT IT FULLY AND ACCURATELY DEPICTS THE LAYOUT OF THE UNIT, ITS LOCATION, APPROXIMATE AREA, MAIN ENTRANCE AND IMMEDIATE COMMON AREA TO WHICH IT HAS ACCESS, AS-BUILT.

- NOTES:**
1. DIMENSIONS SHOWN HEREON ARE TO THE FACE OF FRAMING.
 2. REFERENCE ELEVATION:
 BASEMENT FLOOR - 100'-0"

[Signature]
 REGISTERED ARCHITECT

SHEET 1 OF 3

<p>A COPY OF THE DATA IN THIS DRAWING FILE IS MAINTAINED AT THE OFFICES OF HILL ENGINEERS, ARCHITECTS, PLANNERS, INC. THE INTERPRETATION, CONSTRUCTION AND REVISION OF THIS DATA IS THE SOLE RESPONSIBILITY OF THE USER.</p>	<p>CONDOMINIUM UNIT PLAN SHOWING UNIT #6, TWELVE OAKS VILLAGE, ROUTES 7 & 20, LENOX, MA</p>						
	SCALE	1/16"=1'-0"	REV.	DESCRIPTION	DR'N.	CHK'D.	DATE
DATE	5/30/03	DR'N.	PG	CR'D.			
COMP. CODE		BOOK NO.		CAD CODE	M1688-CU6-B.DWG		
TITLE	BASEMENT FLOOR PLAN UNIT #6			NO.	M1688-CU6-B		REV.

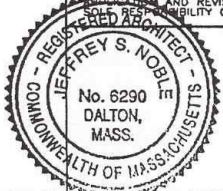

Hill
 engineers
 architects
 planners

50 Depot Street
 Dalton, MA 01228
 (413) 684-0925
 www.hillengineers.com