


BASEMENT
 1461 SQ. FT. (EXCLUDES:
 AREAS LABELED "UNEXCAVATED")

I CERTIFY THAT THIS PLAN SHOWS THE UNIT DESIGNATION OF THE UNIT BEING CONVEYED AND OF IMMEDIATELY ADJOINING UNITS, AND THAT IT FULLY AND ACCURATELY DEPICTS THE LAYOUT OF THE UNIT, ITS LOCATION, APPROXIMATE AREA, MAIN ENTRANCE AND IMMEDIATE COMMON AREA TO WHICH IT HAS ACCESS, AS-BUILT.

- NOTES:**
- DIMENSIONS SHOWN HEREON ARE TO THE FACE OF FRAMING.
 - REFERENCE ELEVATION:
 BASEMENT - 100'-0"


[Signature]
 REGISTERED ARCHITECT

SHEET 1 OF 3

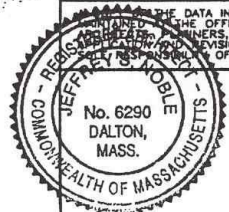

Hill
 engineers
 architects
 planners
 50 Depot Street
 Dalton, MA 01226
 (413) 684-0925
 www.hillengineers.com

CONDOMINIUM UNIT PLAN SHOWING UNIT #7, TWELVE OAKS VILLAGE ROUTES 7 & 20, LENOX, MA			
SCALE	1/16" = 1'-0"	REV.	
DATE	5/19/03	DRN.	CK'D.
DRN.	PG	CK'D.	
APP'VD.			
COMP. CODE		BOOK NO.	CAO CODE M1688-CU7-B-DWG
TITLE	BASEMENT FLOOR PLAN UNIT #7		NO. M1688-CU7-B REV.

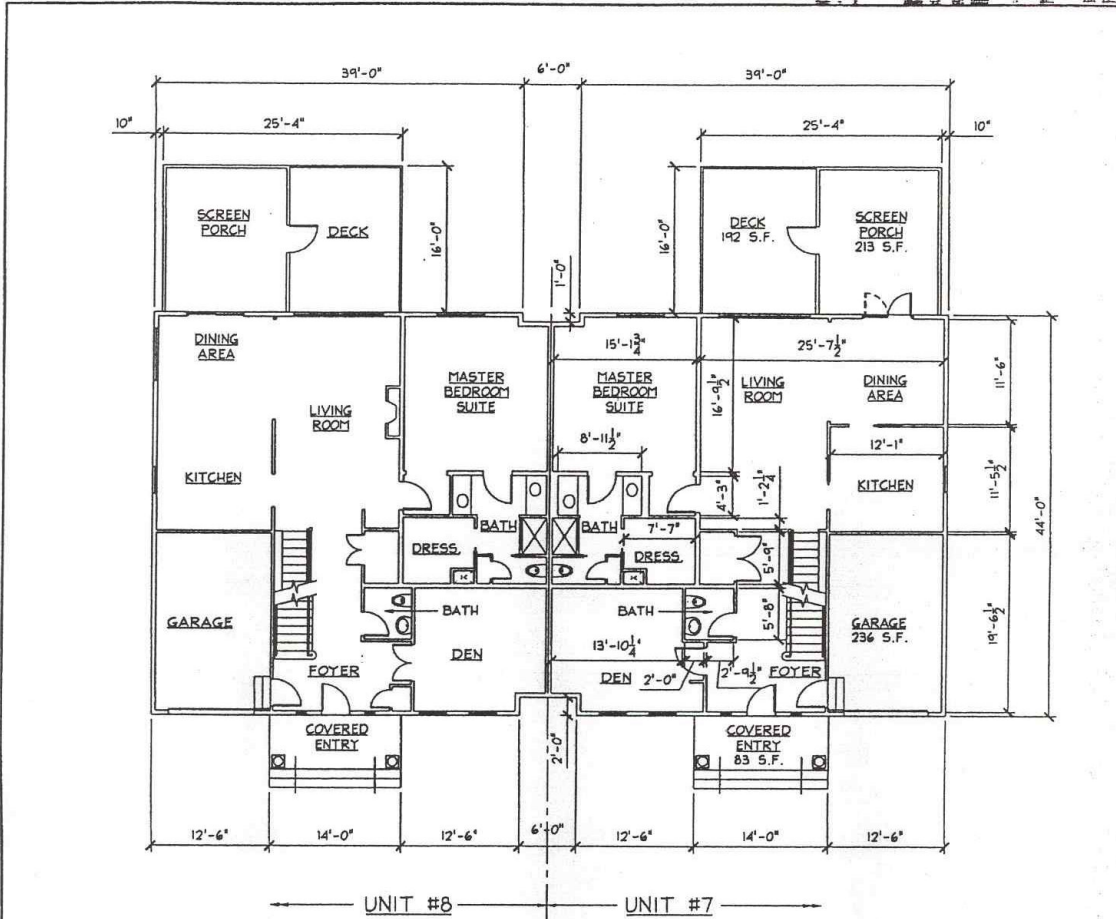

FIRST FLOOR
 1521 SQ. FT., (EXCLUDES:
 AREAS OF DECK, SCREEN PORCH,
 COVERED ENTRY AND GARAGE)

I CERTIFY THAT THIS PLAN SHOWS THE UNIT DESIGNATION OF THE UNIT BEING CONVEYED AND OF IMMEDIATELY ADJOINING UNITS, AND THAT IT FULLY AND ACCURATELY DEPICTS THE LAYOUT OF THE UNIT, ITS LOCATION, APPROXIMATE AREA, MAIN ENTRANCE AND IMMEDIATE COMMON AREA TO WHICH IT HAS ACCESS, AS-BUILT.


[Signature]
 REGISTERED ARCHITECT

NOTES:

1. DIMENSIONS SHOWN HEREON ARE TO THE FACE OF FRAMING.
2. REFERENCE ELEVATION:
 FIRST FLOOR - 109'-4 1/2"

SHEET 2 OF 3

<p>A COPY OF THE DATA IN THIS DRAWING FILE IS MAINTAINED AT THE OFFICES OF HILL ENGINEERS, ARCHITECTS AND PLANNERS, INC. THE INTERPRETATION, APPLICATION AND REVISION OF THIS DATA IS THE SOLE RESPONSIBILITY OF THE USER.</p> <p>Hill eng neers arch itects planners</p> <p>50 Depot Street Dalton, MA 01228 (413) 684-0925 www.hillengineers.com</p>	<p>CONDOMINIUM UNIT PLAN SHOWING UNIT #7, TWELVE OAKS VILLAGE ROUTES 7 & 20, LENOX, MA</p>	
	<p>SCALE 1/16"=1'-0"</p> <p>DATE 5/19/03</p> <p>DRN: PG CK'D:</p> <p>APP'VD:</p> <p>COMP. CODE: BOOK NO. CAD CODE: M1688-CU7-1.DWG</p>	<p>TITLE: FIRST FLOOR PLAN UNIT #7</p> <p>NO. M1688-CU7-1</p>

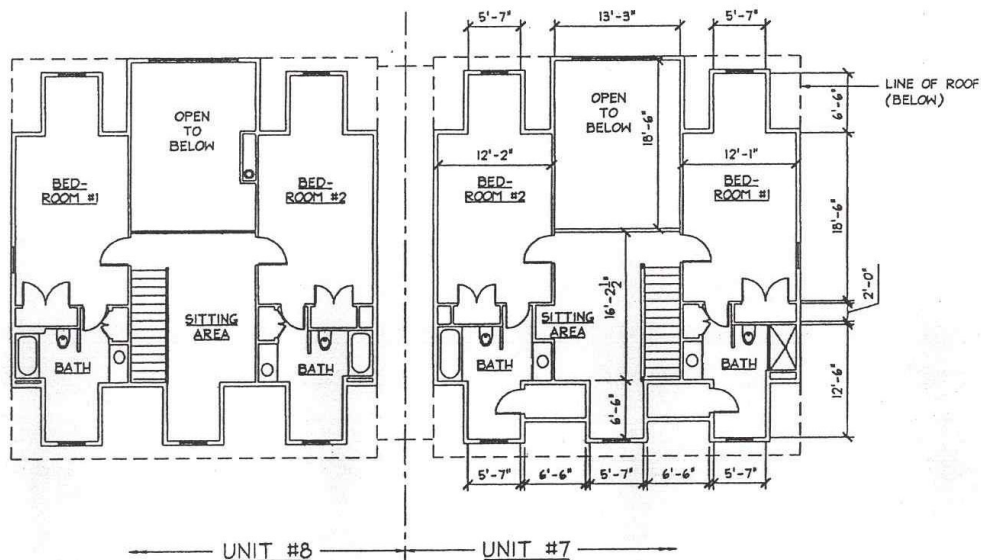

SECOND FLOOR

1132 SQ. FT. (EXCLUDES:
AREA LABELED "OPEN TO BELOW")

I CERTIFY THAT THIS PLAN SHOWS THE UNIT DESIGNATION OF THE UNIT BEING CONVEYED AND OF IMMEDIATELY ADJOINING UNITS, AND THAT IT FULLY AND ACCURATELY DEPICTS THE LAYOUT OF THE UNIT, ITS LOCATION, APPROXIMATE AREA, MAIN ENTRANCE AND IMMEDIATE COMMON AREA TO WHICH IT HAS ACCESS, AS-BUILT.

NOTES:

1. DIMENSIONS SHOWN HEREON ARE TO THE FACE OF FRAMING.
2. REFERENCE ELEVATION:

SECOND FLOOR - 119'-4"

[Signature]
REGISTERED ARCHITECT

SHEET 3 OF 3

<p>A COPY OF THE DATA IN THIS DRAWING FILE IS MAINTAINED AT THE OFFICES OF HILL ENGINEERS, ARCHITECTS - PLANNERS, INC. THE INTERPRETATION, CORRECTION AND REVISION OF THIS DATA IS THE SOLE RESPONSIBILITY OF THE USER.</p>		<p>CONDOMINIUM UNIT PLAN SHOWING UNIT #7, TWELVE OAKS VILLAGE ROUTES 7 & 20, LENOX, MA</p>	
		SCALE: 1/16" = 1'-0"	DESCRIPTION:
		DATE: 5/19/03	DRN: PG
		BOOK NO.	CAD CODE: M1688-CU7-2.DWG
		TITLE: SECOND FLOOR PLAN UNIT #7	NO. M1688-CU7-2

END OF DOCUMENT