

**SECOND FLOOR**

1069 SQ. FT. (EXCLUDES:  
AREA LABELED "OPEN TO BELOW")

I CERTIFY THAT THIS PLAN SHOWS THE UNIT DESIGNATION OF THE UNIT BEING CONVEYED AND OF IMMEDIATELY ADJOINING UNITS, AND THAT IT FULLY AND ACCURATELY DEPICTS THE LAYOUT OF THE UNIT, ITS LOCATION, APPROXIMATE AREA, MAIN ENTRANCE AND IMMEDIATE COMMON AREA TO WHICH IT HAS ACCESS, AS-BUILT.


*[Signature]*  
REGISTERED ARCHITECT

**NOTES:**

1. DIMENSIONS SHOWN HEREON ARE TO THE FACE OF FRAMING.
2. REFERENCE ELEVATION:

SECOND FLOOR - 119'-4"

SHEET 3 OF 3

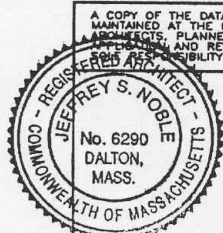


**Hill**  
engineers  
architects  
planners  
50 Depot Street  
Dalton, MA 01226  
(413) 684-0925  
www.hillengineers.com

A COPY OF THE DATA IN THIS DRAWING FILE IS MAINTAINED AT THE OFFICES OF HILL ENGINEERS, ARCHITECTS, PLANNERS, INC. THE INTERPRETATION, APPLICATION AND REVISION OF THIS DATA IS THE RESPONSIBILITY OF THE USER.			
<b>CONDOMINIUM UNIT PLAN</b> SHOWING UNIT #8, TWELVE OAKS VILLAGE ROUTES 7 & 20, LENOX, MA			
SCALE	1/16"=1'-0"	REV	
DATE	5/27/03	DRN	CR'D
DRN	PG	CR'D	
APP'VD.			
COMP. CODE		BOOK NO.	
TITLE	SECOND FLOOR PLAN UNIT #8		NO. M1688-CU8-2
		DO CODE	M1688-CU8-2.DWG
			REV.

**END OF DOCUMENT**

S:\CAD\Current\11688-CU8-2.dwg - plans\11688-CU8-2.dwg, 06/11/2003 07:56:58 AM, gahp, 1:1

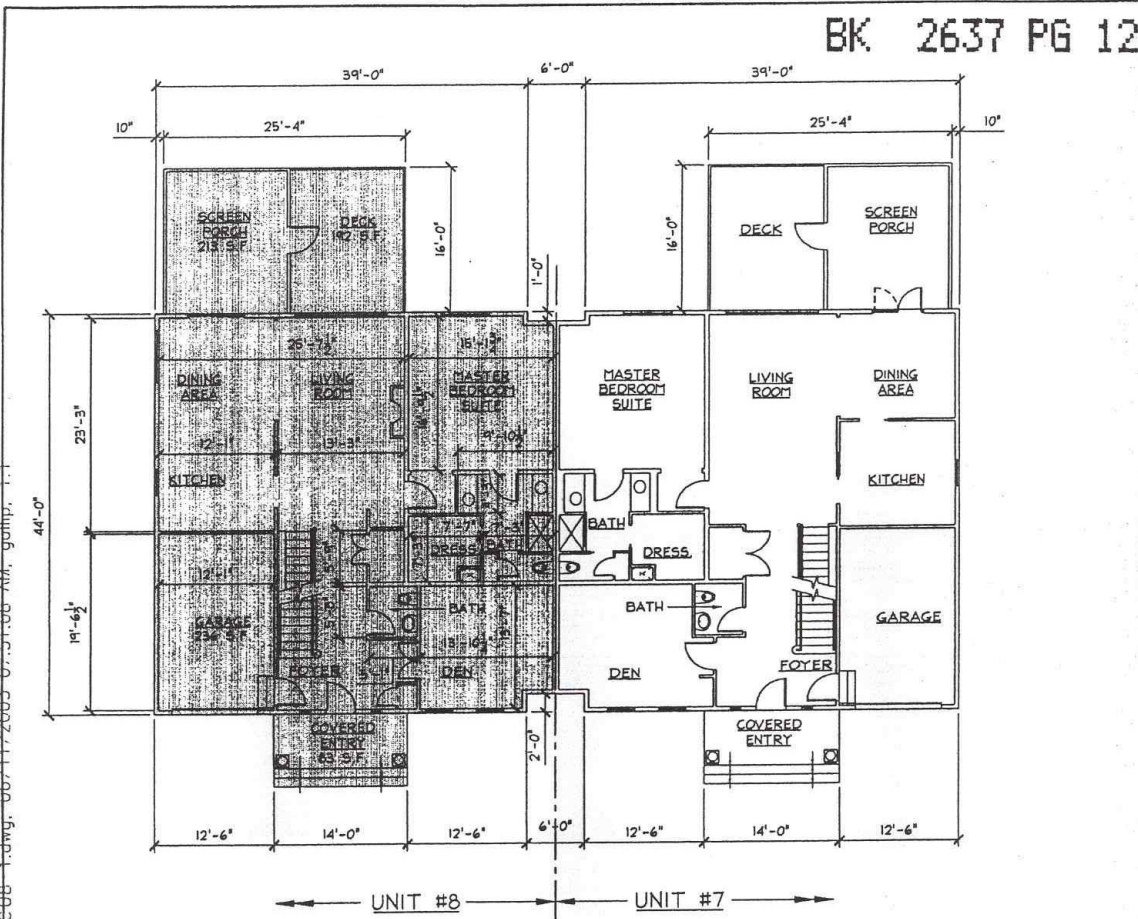

**FIRST FLOOR**  
 1521 SQ. FT., (EXCLUDES:  
 AREAS OF DECK, SCREEN PORCH,  
 COVERED ENTRY AND GARAGE)

I CERTIFY THAT THIS PLAN SHOWS THE UNIT DESIGNATION OF THE UNIT BEING CONVEYED AND OF IMMEDIATELY ADJOINING UNITS, AND THAT IT FULLY AND ACCURATELY DEPICTS THE LAYOUT OF THE UNIT, ITS LOCATION, APPROXIMATE AREA, MAIN ENTRANCE AND IMMEDIATE COMMON AREA TO WHICH IT HAS ACCESS, AS-BUILT.


*[Signature]*  
 REGISTERED ARCHITECT

**NOTES:**

1. DIMENSIONS SHOWN HEREON ARE TO THE FACE OF FRAMING.

2. REFERENCE ELEVATION:  
 FIRST FLOOR - 104'-4 1/2"


SHEET 2 OF 3

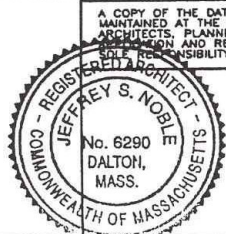

**Hill**  
 engineers  
 architects  
 planners  
 50 Depot Street  
 Dalton, MA 01228  
 (413) 684-0925  
 www.hillengineers.com

<b>CONDOMINIUM UNIT PLAN</b>			
SHOWING UNIT #8, TWELVE OAKS VILLAGE ROUTES 7 & 20, LENOX, MA			
SCALE	1/16" = 1'-0"	REV.	DESCRIPTION
DATE	5/27/03	DR'N.	CR'D.
DR'N.	PG	CR'D.	
AP'VD.			
COMP. CODE	BOOK NO.	DAO CODE	M1688-CUB-1.DWG
TITLE	FIRST FLOOR PLAN UNIT #8	NO.	M1688-CUB-1
		REV.	

S:\C:\D:\Content\111\111-606\units-7&8\condo-plans\1688-CUB-1.dwg, 06/11/2003 07:51:00 AM, gollip, 1:1

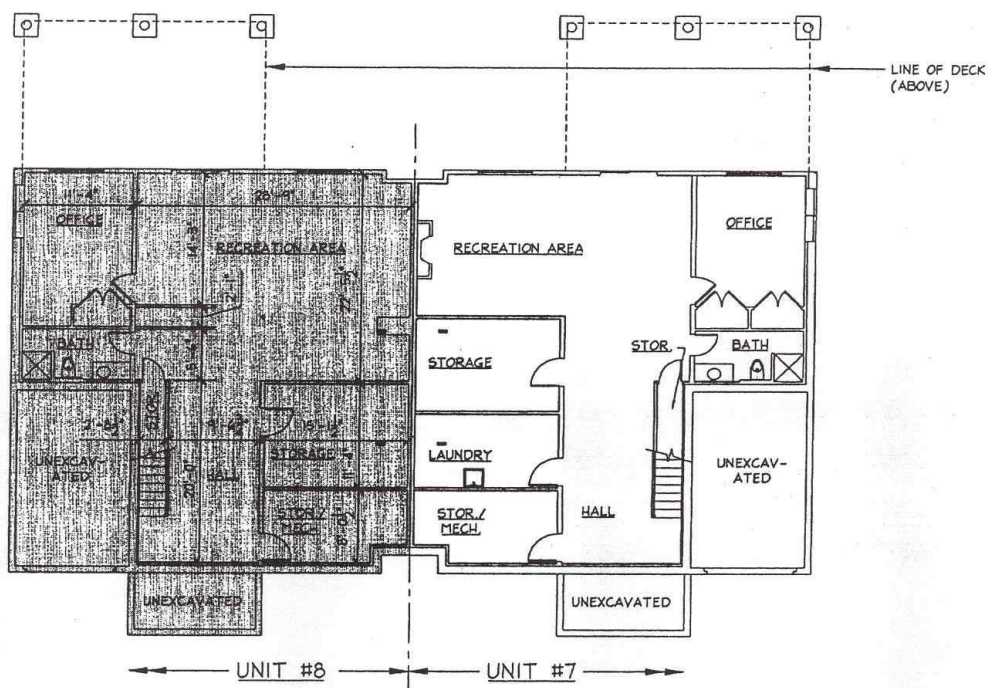

**BASEMENT**  
 1461 SQ. FT. (EXCLUDES:  
 AREAS LABELED "UNEXCAVATED")

I CERTIFY THAT THIS PLAN SHOWS THE UNIT DESIGNATION OF THE UNIT BEING CONVEYED AND OF IMMEDIATELY ADJOINING UNITS, AND THAT IT FULLY AND ACCURATELY DEPICTS THE LAYOUT OF THE UNIT, ITS LOCATION, APPROXIMATE AREA, MAIN ENTRANCE AND IMMEDIATE COMMON AREA TO WHICH IT HAS ACCESS, AS-BUILT.

*[Signature]*  
 REGISTERED ARCHITECT

- NOTES:**
1. DIMENSIONS SHOWN HEREON ARE TO THE FACE OF FRAMING.
  2. REFERENCE ELEVATION:  
 BASEMENT - 100'-0"

SHEET 1 OF 3



**Hill**  
 engineers  
 architects  
 planners  
 50 Depot Street  
 Dalton, MA 01226  
 (413) 684-0825  
 www.hillengineers.com

CONDOMINIUM UNIT PLAN SHOWING UNIT #8, TWELVE OAKS VILLAGE ROUTES 7 & 20, LENOX, MA					
SCALE	1/16" = 1'-0"	DESCRIPTION	DRN	CHK'D	DATE
DATE	5/27/03				
DRN	PG	CHK'D			
APP'VD.					
COMP. CODE		BOOK NO.	CAO CODE	M1688-CU8-B.DWG	
TITLE			NO.	REV.	
BASEMENT FLOOR PLAN UNIT #8			M1688-CU8-B		

S:\CAD\CURRENT\11\11-688\condo-plans\M1688-CU8-B.dwg, 06/11/2003 07:56:44 AM, gmpj, 1:1